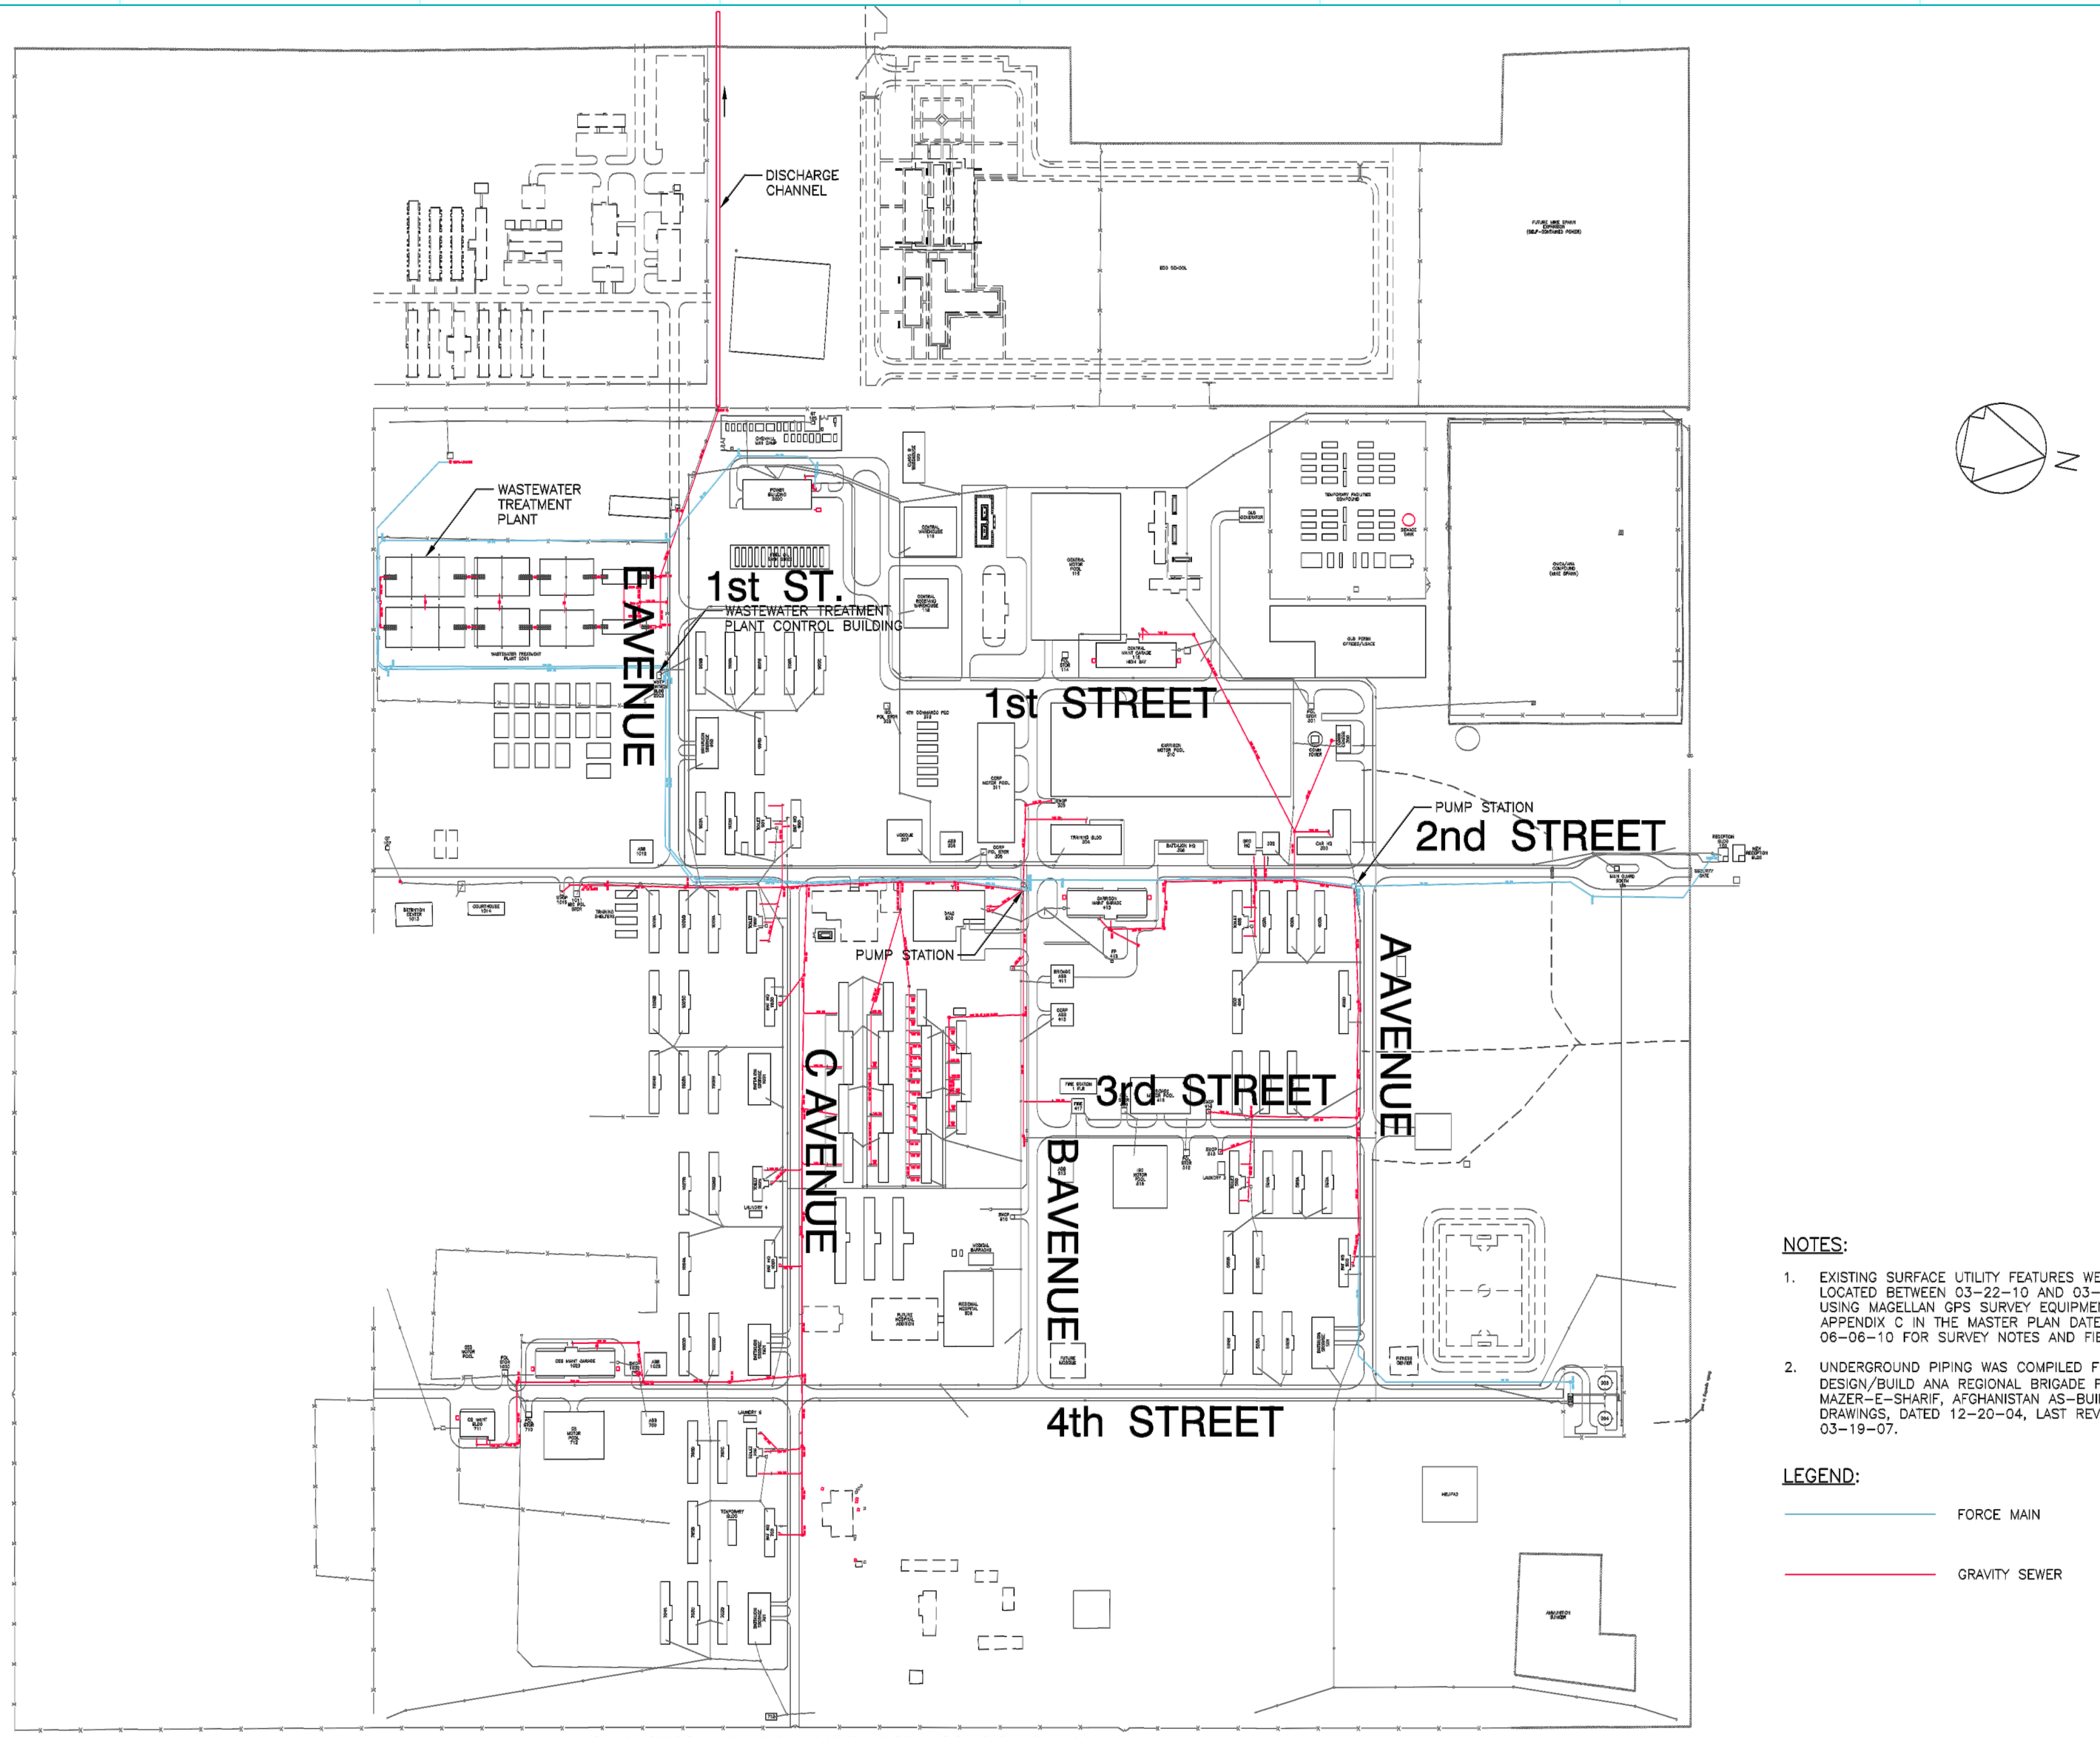

EXISTING SEWER INFRASTRUCTURE PLAN
SCALE 1:3000

UNLESS OTHERWISE NOTED, ALL DIMENSIONS SHOWN ARE IN METERS.

NOTES:

1. EXISTING SURFACE UTILITY FEATURES WERE FIELD LOCATED BETWEEN 03-22-10 AND 03-26-10 USING MAGELLAN GPS SURVEY EQUIPMENT. SEE APPENDIX C IN THE MASTER PLAN DATED 06-06-10 FOR SURVEY NOTES AND FIELD DATA.
2. UNDERGROUND PIPING WAS COMPILED FROM DESIGN/BUILD ANA REGIONAL BRIGADE FACILITIES MAZER-E-SHARIF, AFGHANISTAN AS-BUILT DRAWINGS, DATED 12-20-04, LAST REVISED 03-19-07.

LEGEND:

FORCE MAIN

GRAVITY SEWER

100 0 100 200
1:3000

US ARMY CORPS OF ENGINEERS AFGHANISTAN ENGINEER DISTRICT

U.S. ARMY ENGINEER DISTRICT, AFGHANISTAN
CORPS OF ENGINEERS
APO AE 96338

ENGINEERING AND CONSTRUCTION DIVISION

STANDARD DRAWING
PROJECT LOCATION
BUILDING TYPE
CAMP SHAHEEN EXISTING SEWER

SHEET REFERENCE NUMBER:
X-XXX
SHEET — OF —