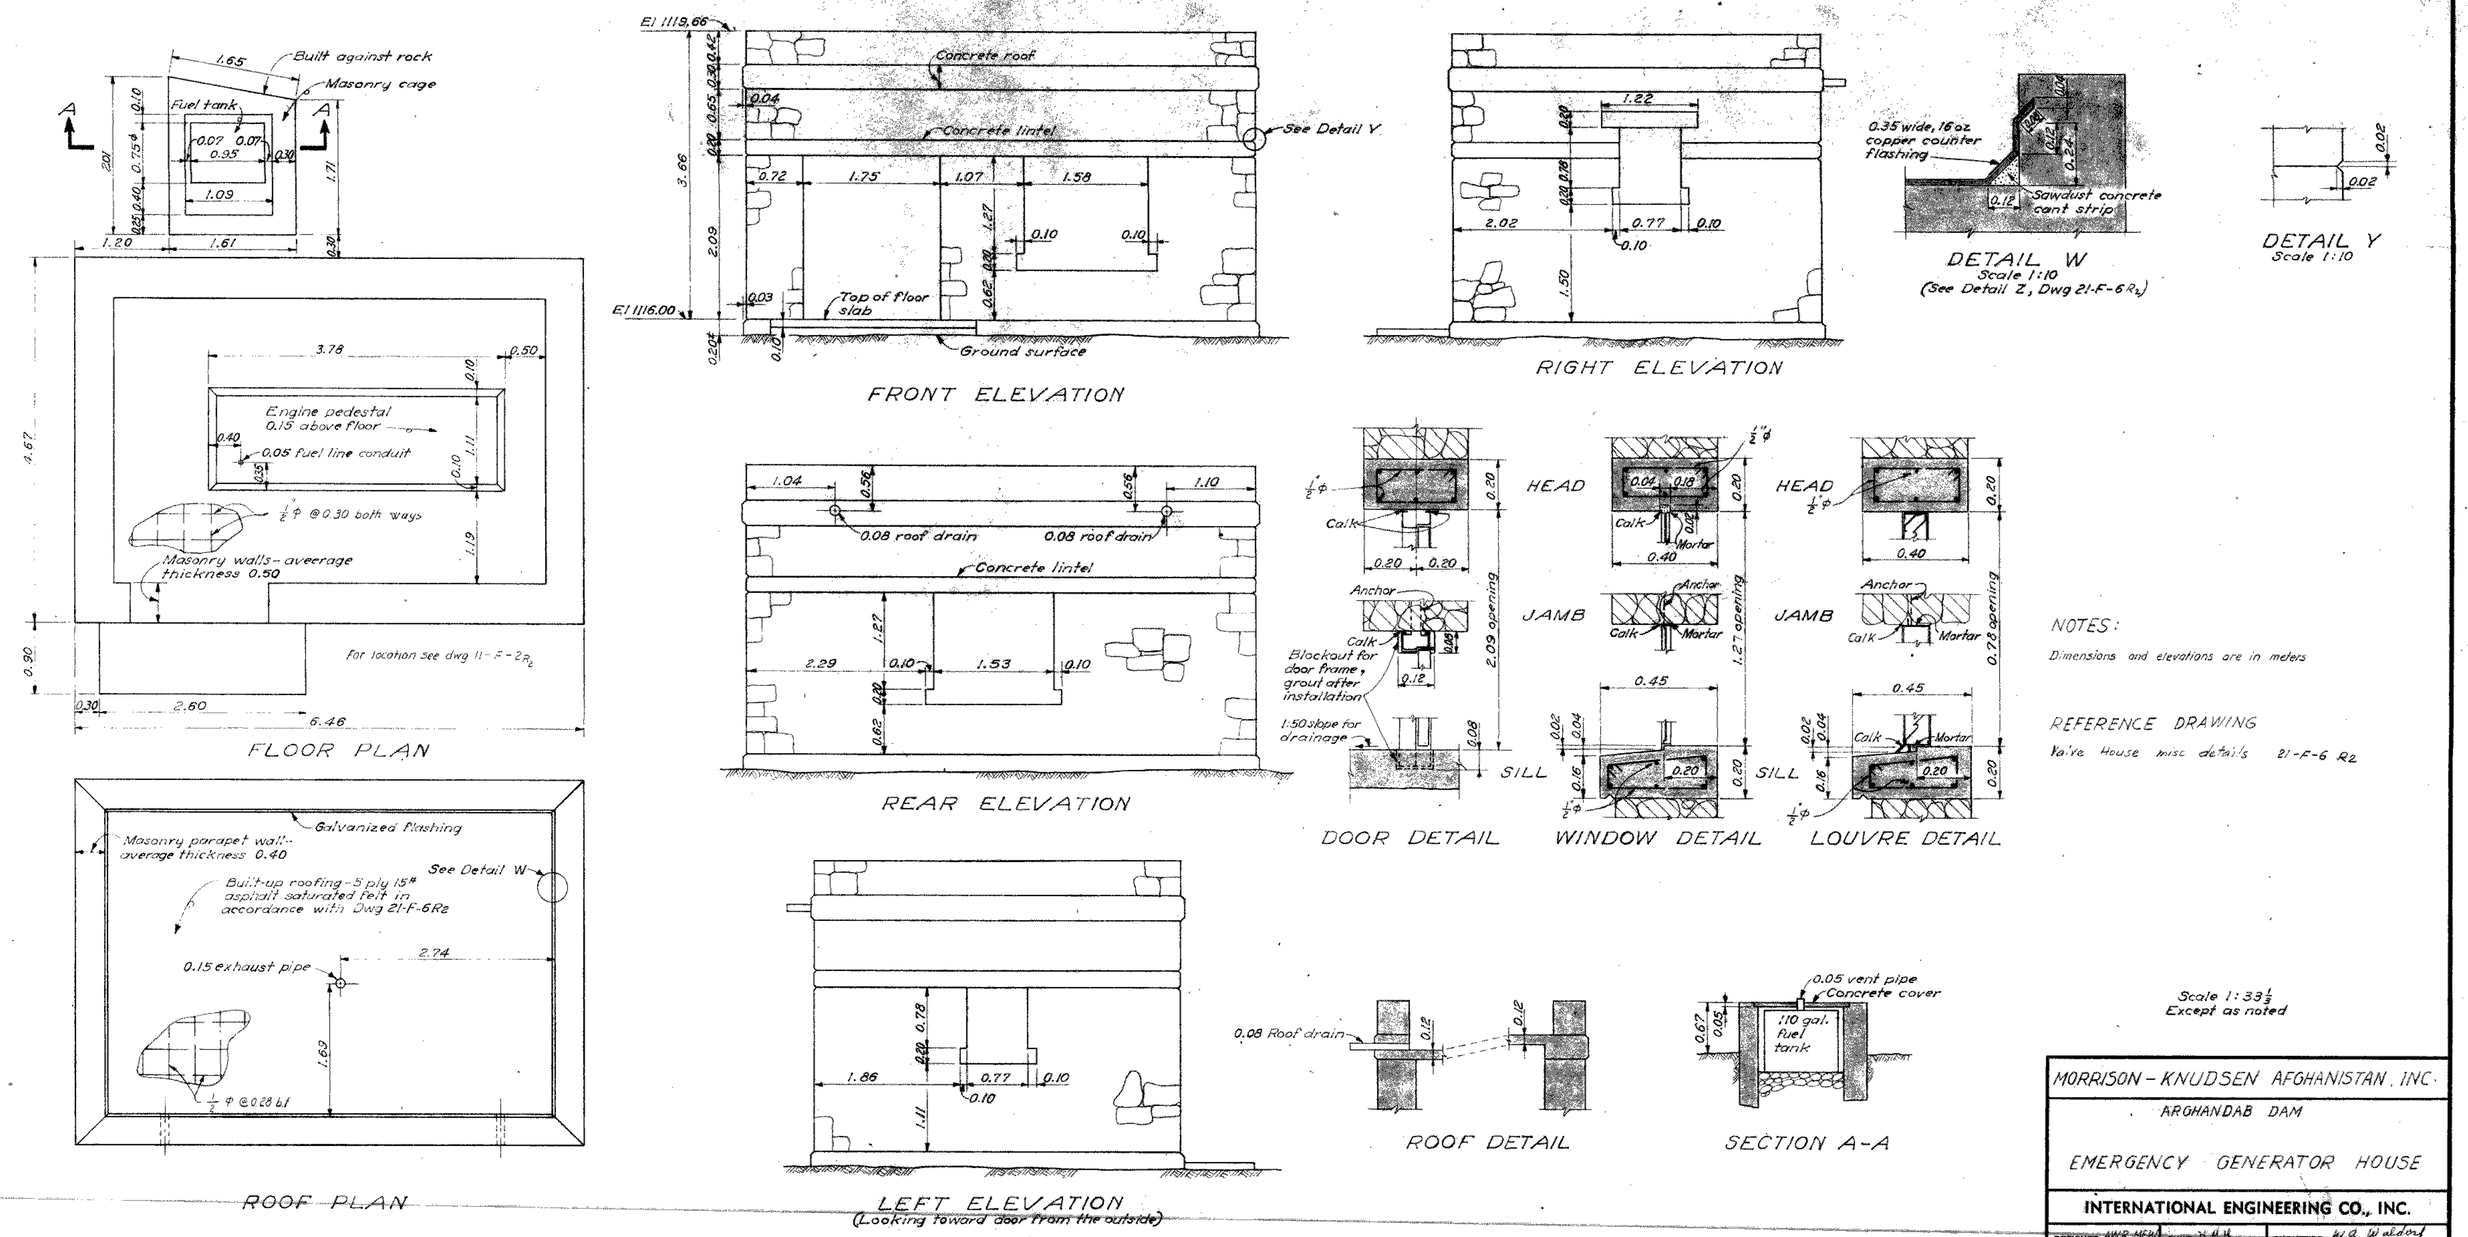

NOTES:

Dimensions and elevations are in meters

REFERENCE DRAWING

Valve House misc details 21-F-6 R2

Scale 1:33 1/3
Except as noted

MORRISON - KNUDSEN AFGHANISTAN, INC.

ARGHANDAB DAM

EMERGENCY GENERATOR HOUSE

INTERNATIONAL ENGINEERING CO., INC.

DESIGNED AWR MFW | CHKD. H.H.H. | SUBMITTED W.A. Waldorf
DRAWN AWR CHY | INSP. CML | RECOMMENDED W.W. Berkeland
APPROVED F. Mundal

REV. NO.	DATE	MADE	CHECKED	APPROVED
1	As Built 6-15-55	JRF	VIT	

13-F-30R1

SAN FRANCISCO, CAL.
DATE JUNE 17, 1952